


AMENDMENTS:		
AMENDMENT	DATE	DESCRIPTION

NOTES:

- This plan has been prepared to show sewer, stormwater & water asbuilt locations only. No liability is accepted if the plan is used for any other purpose.
- Any measurements taken from information which is not dimensioned on the electronic copy are at the risk of the recipient.
- Stormwater laterals are Ø100mm uPVC.
- Asbuilt service locations have been provided by Rooney Earthmoving Ltd. No liability is accepted in relation to their accuracy.

LEGEND:

ASBUILT WATER		WATER METER		VALVE	
ASBUILT PRESSURE SEWER		BOUNDARY BOX		FLUSHING POINT	
ASBUILT STORMWATER		STORMWATER LATERAL			
ASBUILT KERB		SUMP		DOUBLE SUMP	
ASBUILT FOOTPATH					



DAVIE LOVELL-SMITH
PLANNING SURVEYING ENGINEERING

116 Wrights Road P O Box 679 Christchurch 8140. New Zealand
Telephone: 03 379-0793 Website: www.dls.co.nz E-mail: office@dls.co.nz


JOB TITLE:
Sabys Estate Stages 1 & 2A

SHEET TITLE:
Asbuilt Sewer, Stormwater & Water

DRAWING STATUS:
For Information Purposes

SCALE: 1:375@A1 DATE: August 2022
1:750@A3

DRAWING No: E20106	SHEET No: SP01.0	DRAWN: JS REVISION: R0
------------------------------	----------------------------	-------------------------------------

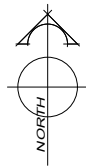


AMENDMENTS:		
AMENDMENT	DATE	DESCRIPTION

NOTES:

1. This plan has been prepared to show sewer, stormwater & water asbuilt locations only. No liability is accepted if the plan is used for any other purpose.
2. Any measurements taken from information which is not dimensioned on the electronic copy are at the risk of the recipient.
3. Stormwater laterals are Ø100mm uPVC.
4. Asbuilt service locations have been provided by Rooney Earthmoving Ltd. No liability is accepted in relation to their accuracy.

LEGEND:

ASBUILT WATER		WATER METER		VALVE	
ASBUILT PRESSURE SEWER		BOUNDARY BOX		FLUSHING POINT	
ASBUILT STORMWATER		STORMWATER LATERAL			
ASBUILT KERB		SUMP		DOUBLE SUMP	
ASBUILT FOOTPATH					

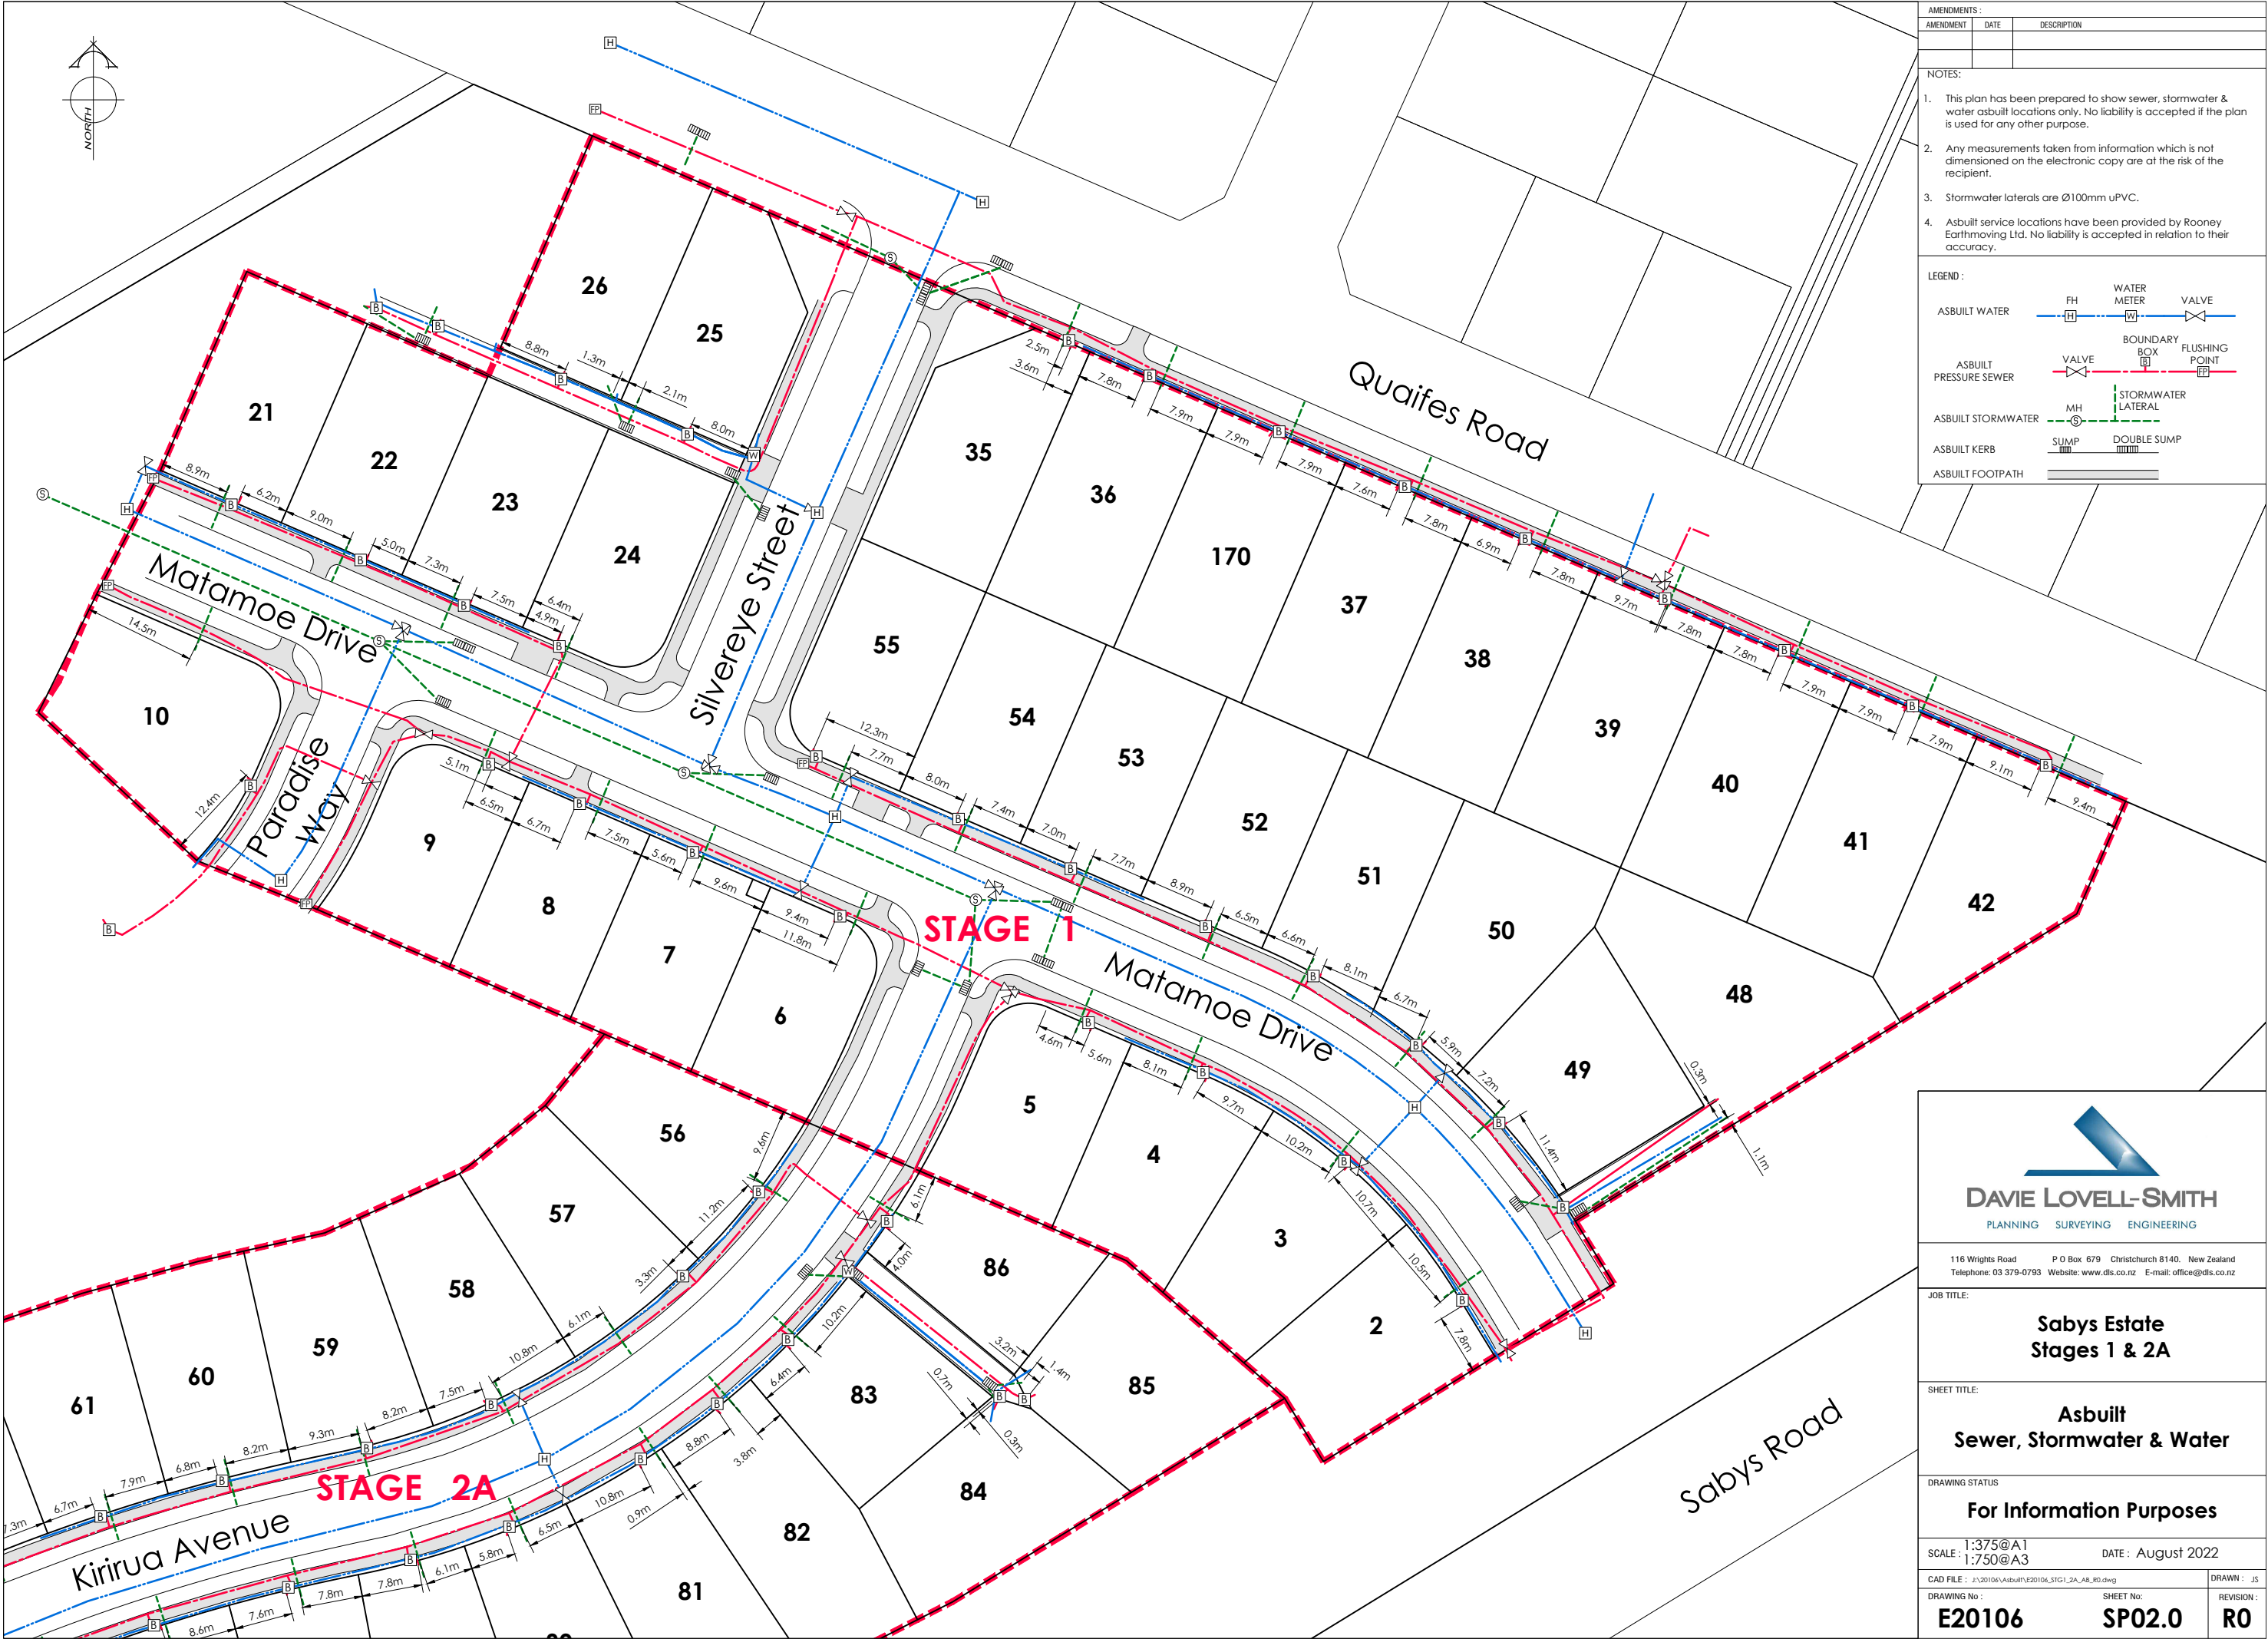

116 Wrights Road P O Box 679 Christchurch 8140. New Zealand
Telephone: 03 379-0793 Website: www.dls.co.nz E-mail: office@dls.co.nz

JOB TITLE:
Sabys Estate Stages 1 & 2A

SHEET TITLE:
Asbuilt Sewer, Stormwater & Water

DRAWING STATUS:
For Information Purposes

SCALE: 1:375@A1 DATE: August 2022
1:750@A3

CAD FILE: J:\2010\Asbuilt\E20106_STG1_2A_AB_R0.dwg DRAWN: JS
DRAWING No: **E20106** SHEET No: **SP02.0** REVISION: **R0**